


AM Peak
8:00-9:00
KEY:
--- Site Access
24 PCUs

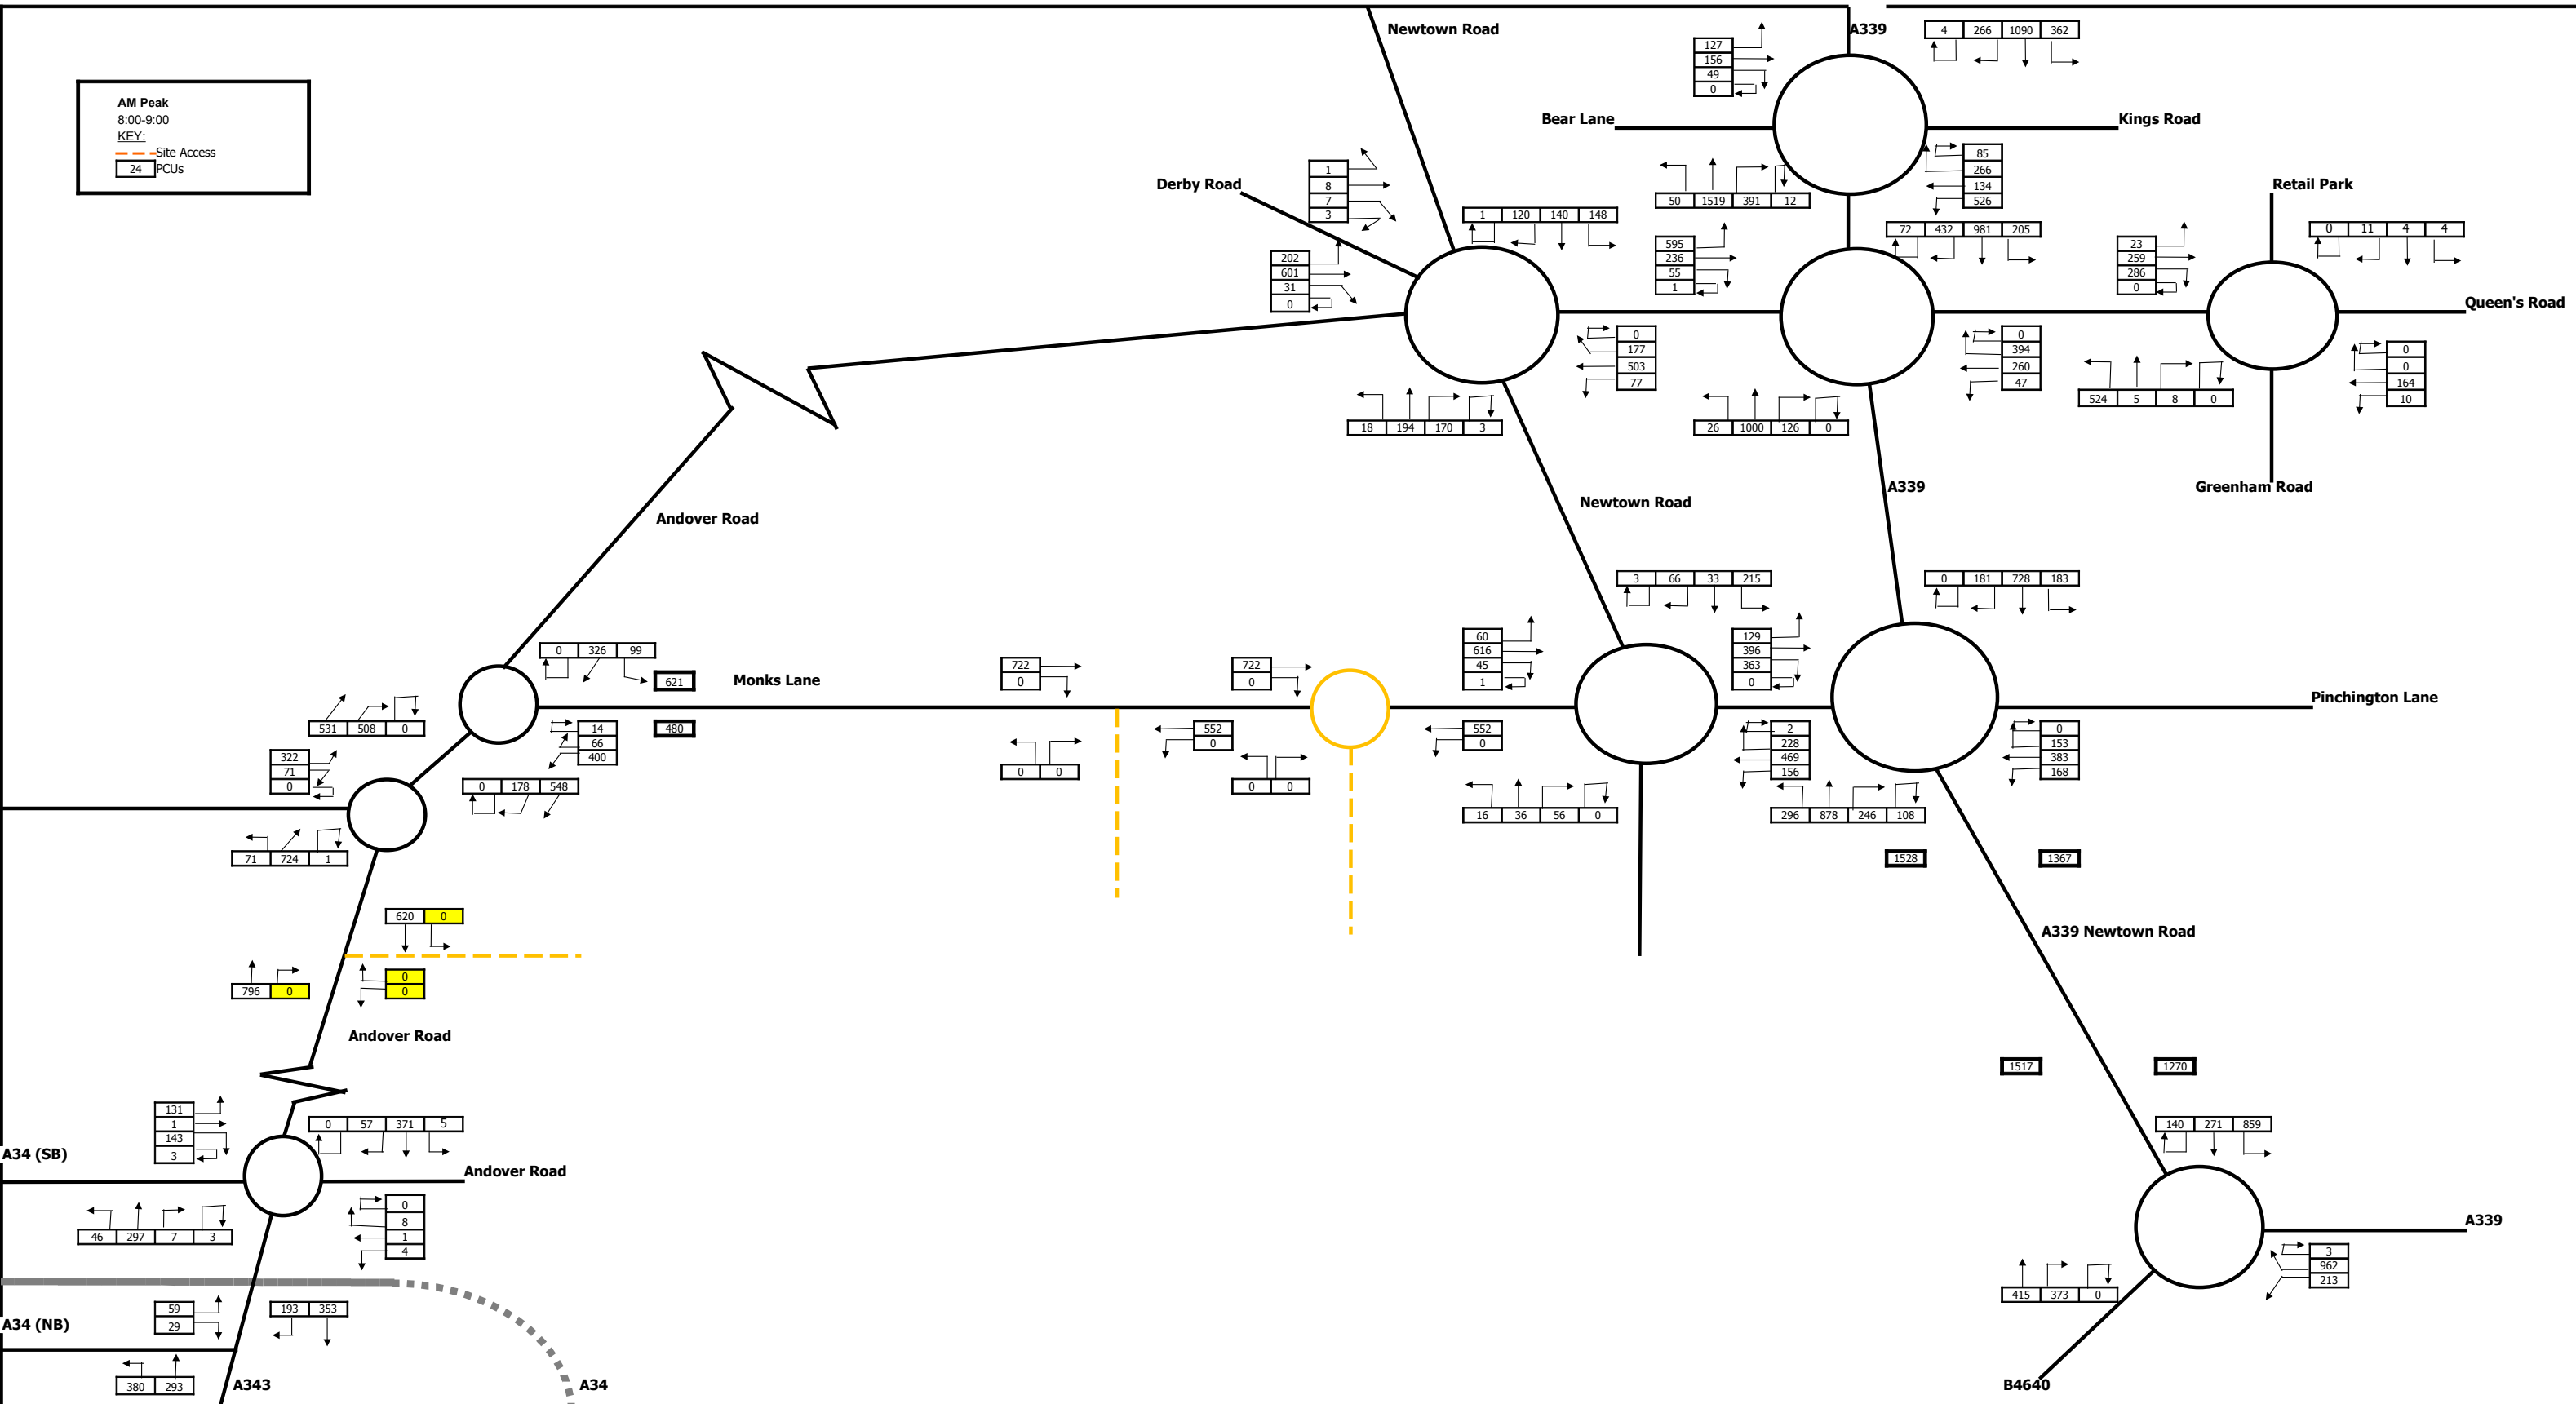


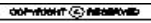
Rev	Team	Drawn	Checked	Approved	Project
A	2818	CL	AW	MG	Sandleford Park, Newbury
Project No.	File name		Title		
A057750	Sandleford Park		AM Peak - Traffic Survey (2012)		

Client	Skilldraw Limited
Project	Sandleford Park, Newbury
AM Peak - Traffic Survey (2012)	


Ropemaker Court
12 Lower Park Row
Bristol
BS1 5BN

Telephone: (0117) 311 6387
Facsimile: (0117) 925 4239
Email: sba@sbox.co.uk

 Savell Bird & Axon
part of the WYG group



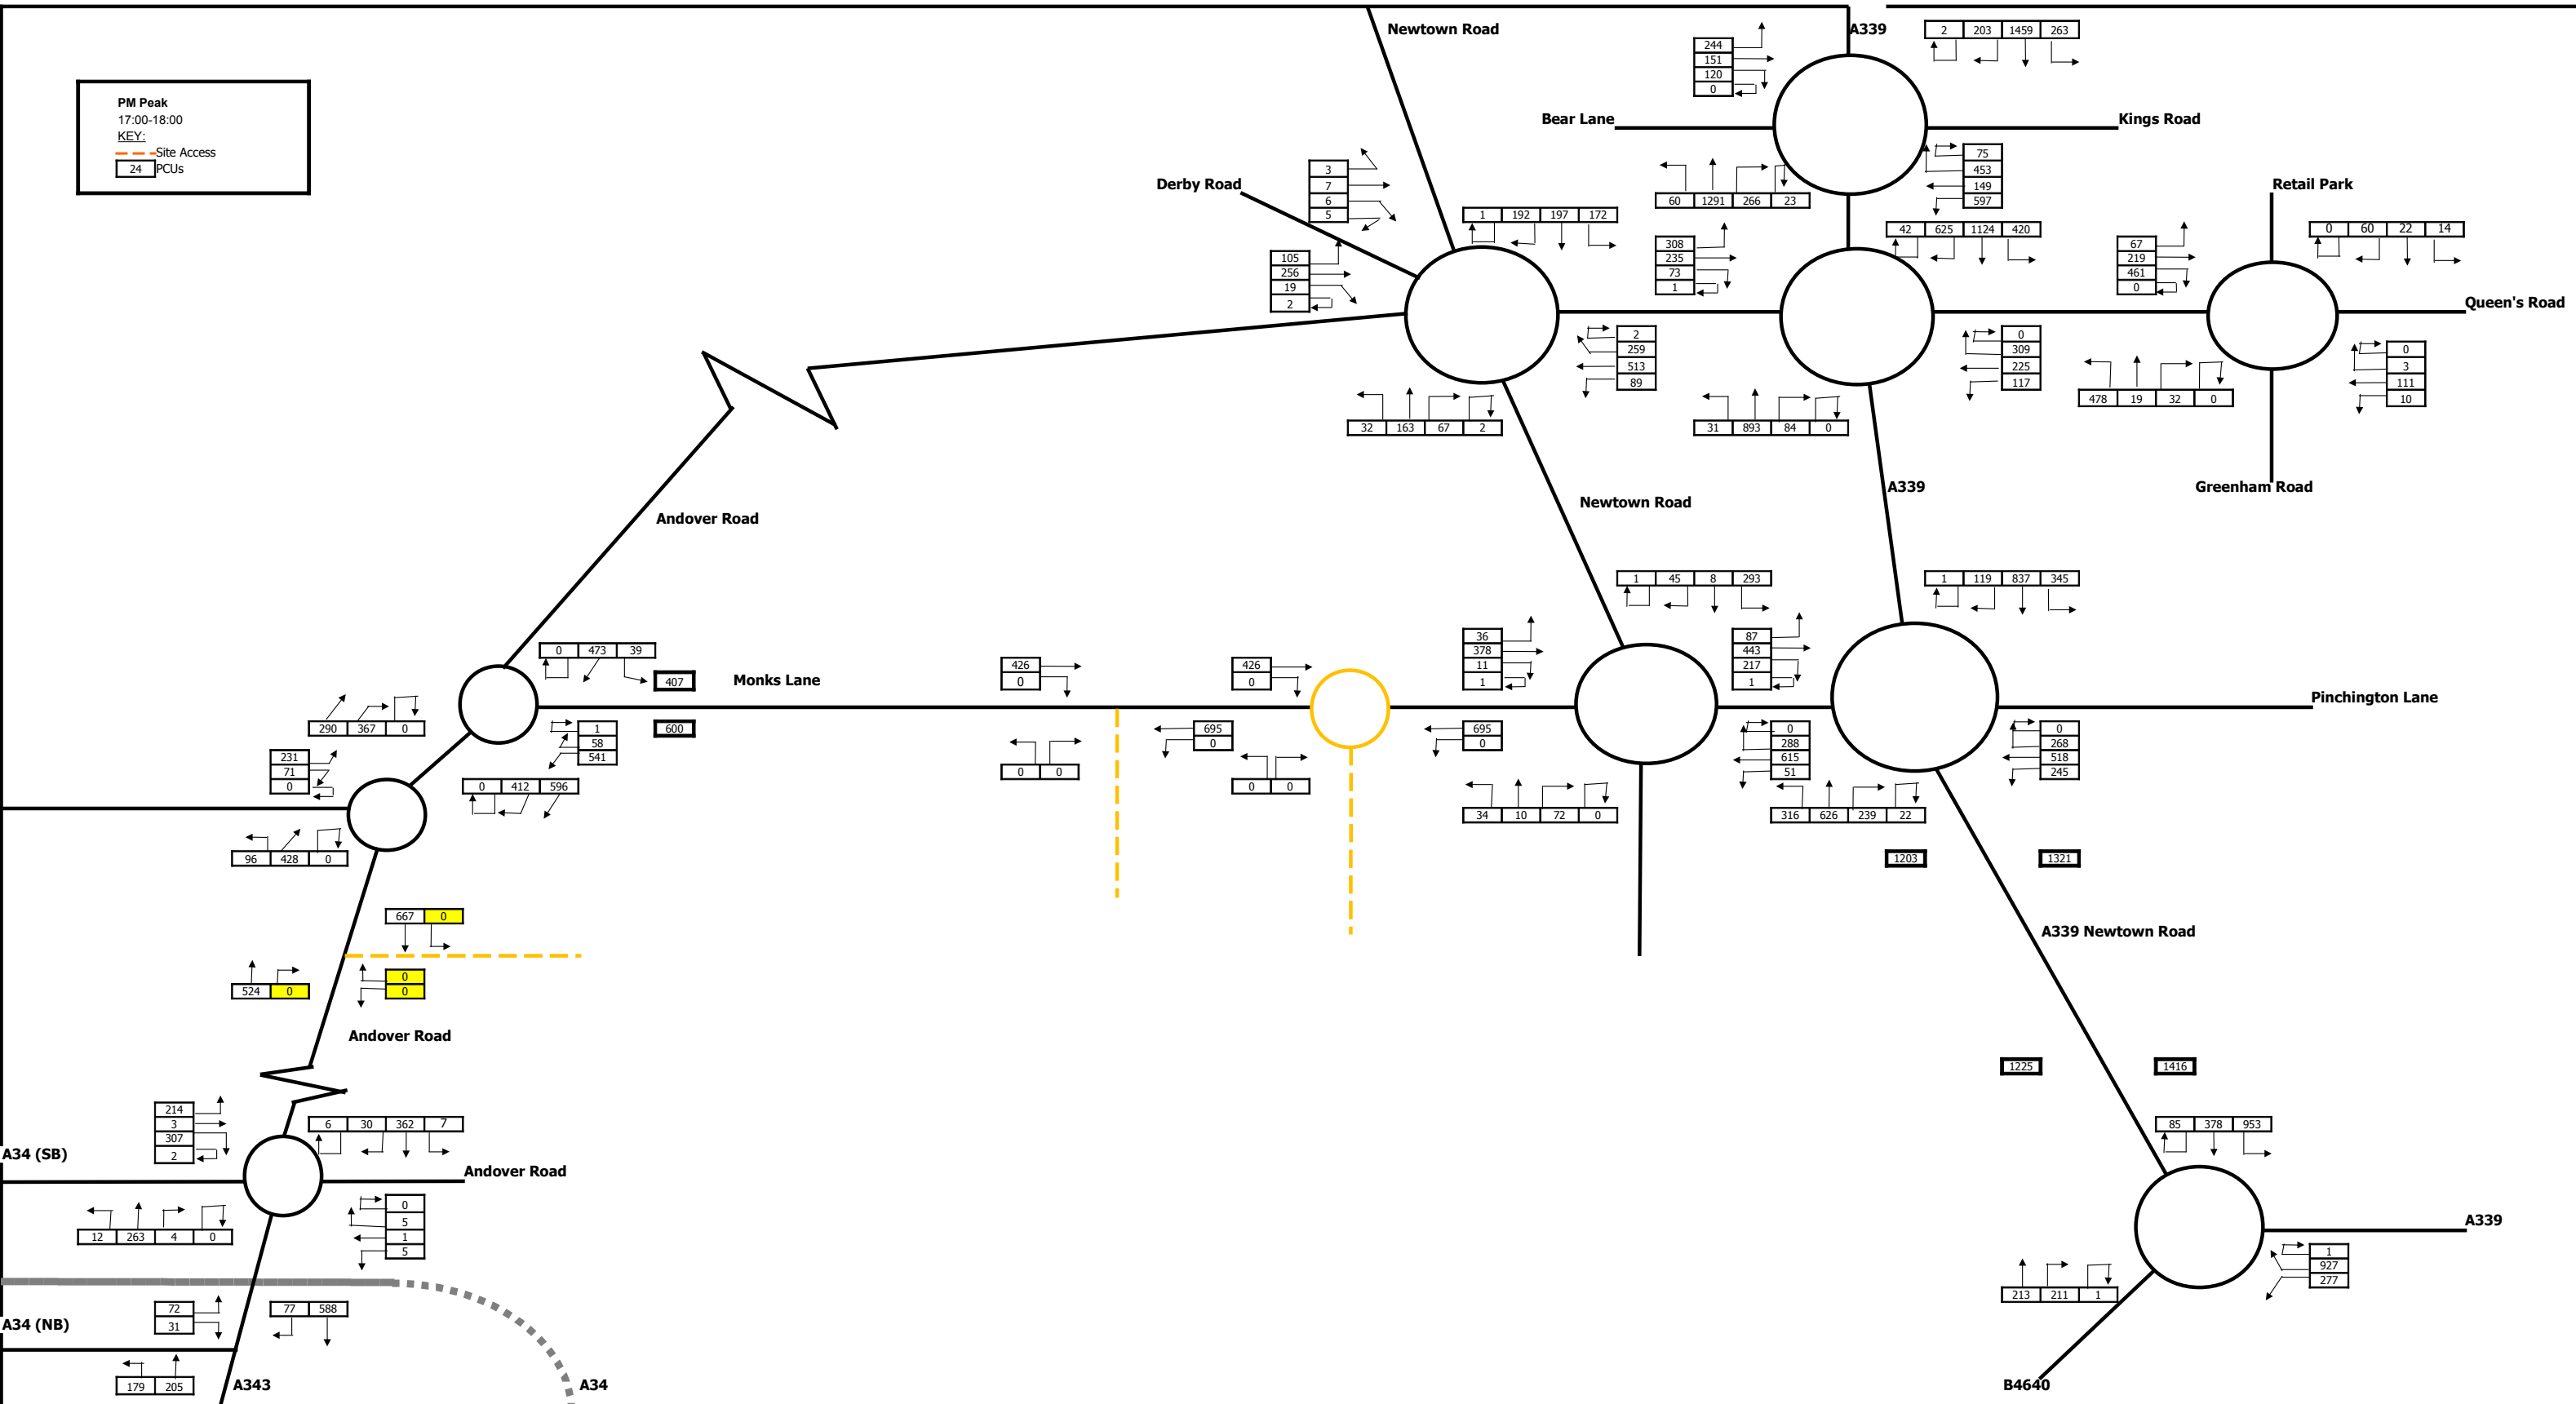

PM Peak
17:00-18:00
KEY:
--- Site Access
24 PCUs



Rev	Team	Drawn	Checked	Approved	Project
A	2818	CL	AW	MG	Sandleford Park, Newbury
Project No.	File name		Title		
A057750	Sandleford Park		PM Peak - Traffic Survey (2012)		

Client	Skilldraw Limited
Project	Sandleford Park, Newbury
Ropemaker Court 12 Lower Park Row Bristol BS1 5BN	
Telephone: (0117) 311 6387 Facsimile: (0117) 925 4239 Email: sba@sbox.co.uk	


Savell Bird & Axon
 part of the WYG group



Trip Rates

WBC Models & Glanville TA

	AM	PM
Arrivals	0.12	0.38
Departures	0.44	0.20
Total	0.56	0.58

	Residential		2000	Dwellings
	IN		OUT	
	Trip Rate	Trips	Trip Rate	Trips
AM	0.12	240	0.44	880
PM	0.38	760	0.20	400

Agreed Trip Rates - Newbury Race Course TA

	AM	PM
Arrivals	0.060	0.370
Departures	0.450	0.160
Total	0.510	0.530

	Residential		2000	Dwellings
	IN		OUT	
	Trip Rate	Trips	Trip Rate	Trips
AM	0.060	120	0.450	900
PM	0.370	740	0.160	320

Distribution is based on census data for the St Johns and Falkland Wards as these are the two closet wards and parts of the sites fall within both wards.



AM	IN	OUT	AM	IN	OUT
B4640	4.6%	4.6%	B4640	4.6%	4.6%
A343 South	1.5%	1.5%	A343 South	1.5%	1.5%
A34 South	2.0%	2.0%	A34 South	2.0%	2.0%
A34 North	28.7%	28.7%	A34 North	28.7%	28.7%
A339 East	6.2%	6.2%	A339 East	6.2%	6.2%
A339 North	20.2%	20.2%	A339 North	20.2%	20.2%


Following Discussions with WBC the distribution has been amended as per the WBC SATURN model.

Changes are shown in Red

AM	IN	OUT	PM	IN	OUT
B4640	4.6%	4.6%	B4640	4.6%	4.6%
A343 South	3.15%	1.5%	A343 South	1.5%	1.5%
A34 South	21.00%	2.0%	A34 South	11.35%	2.0%
A34 North	16.00%	28.7%	A34 North	16.7%	28.7%
A339 East	6.2%	6.2%	A339 East	13.2%	6.2%
A339 North	14.25%	17.95%	A339 North	20.0%	20.9%

AM Peak
8:00-9:00

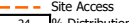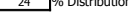KEY:
 Site Access
 24% Distribution

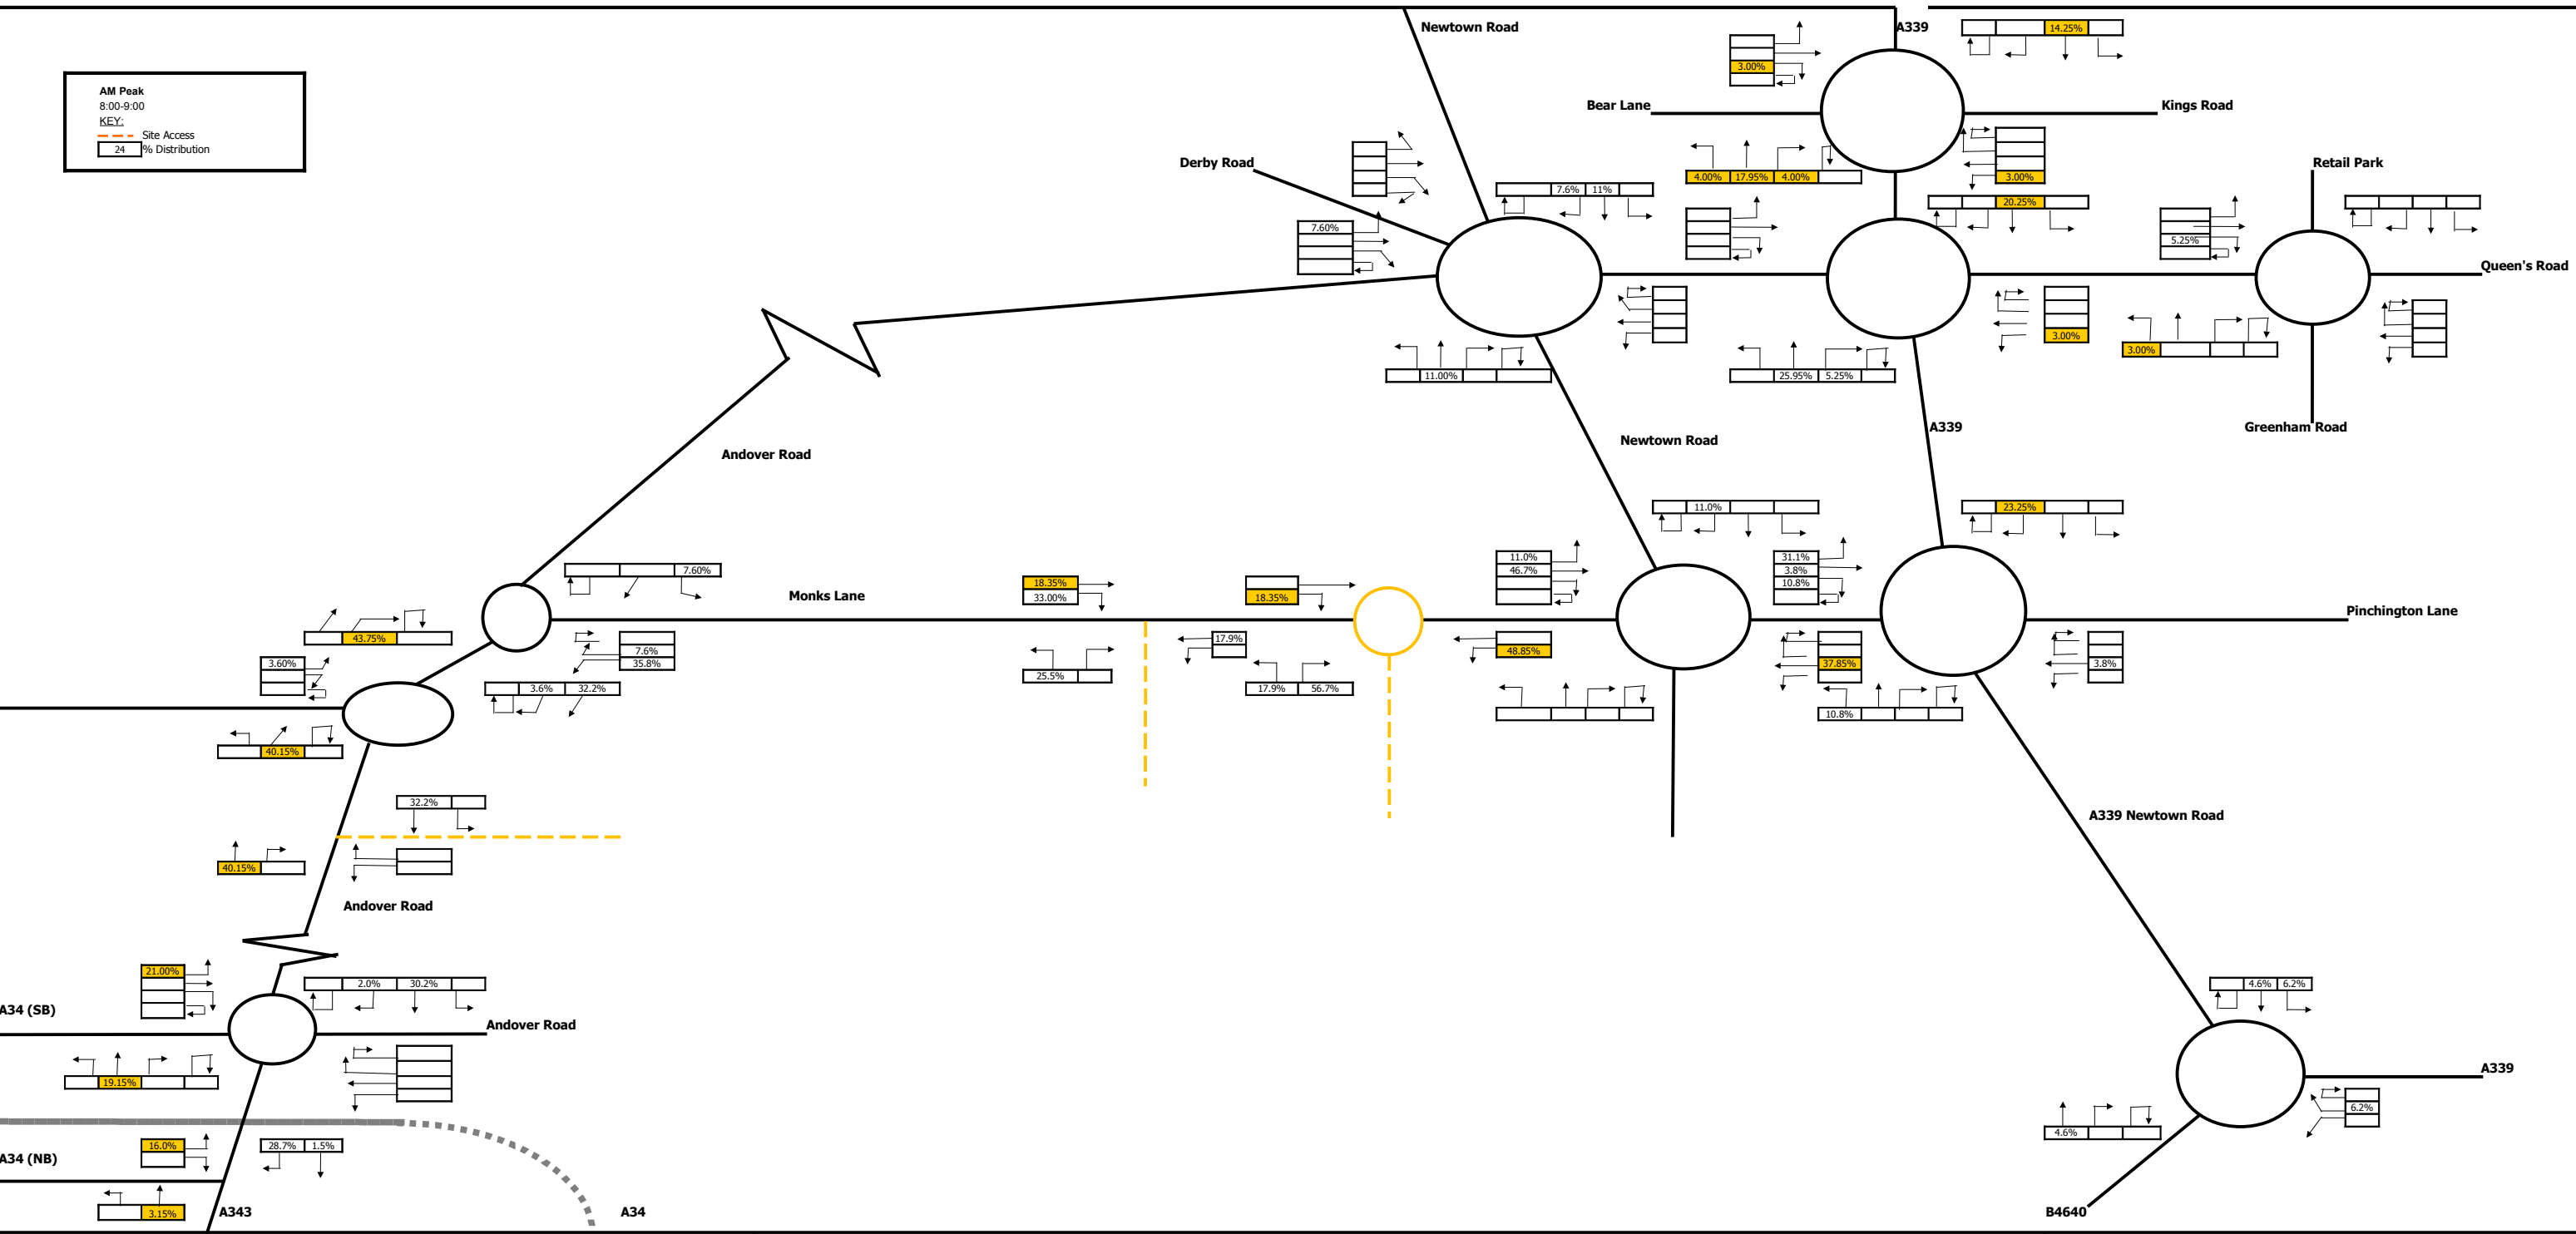

Rev	Team	Drawn	Checked	Approved
A	2818	CL	AW	MG
Project No. A057750		File name Sandford Park		


Client	Skilldraw Limited		
Project	Sandford Park, Newbury		
Title	AM Peak - Distribution		

Ropemaker Court
12 Lower Park Row
Bristol
BS1 5BN

 Savell Bird & Axon
part of the WYG group

Telephone: (0117) 311 6387
Facsimile: (0117) 925 4239
Email: sba@sba.co.uk

PM Peak
17:00-18:00
KEY:
- - Site Access
24 % Distribution

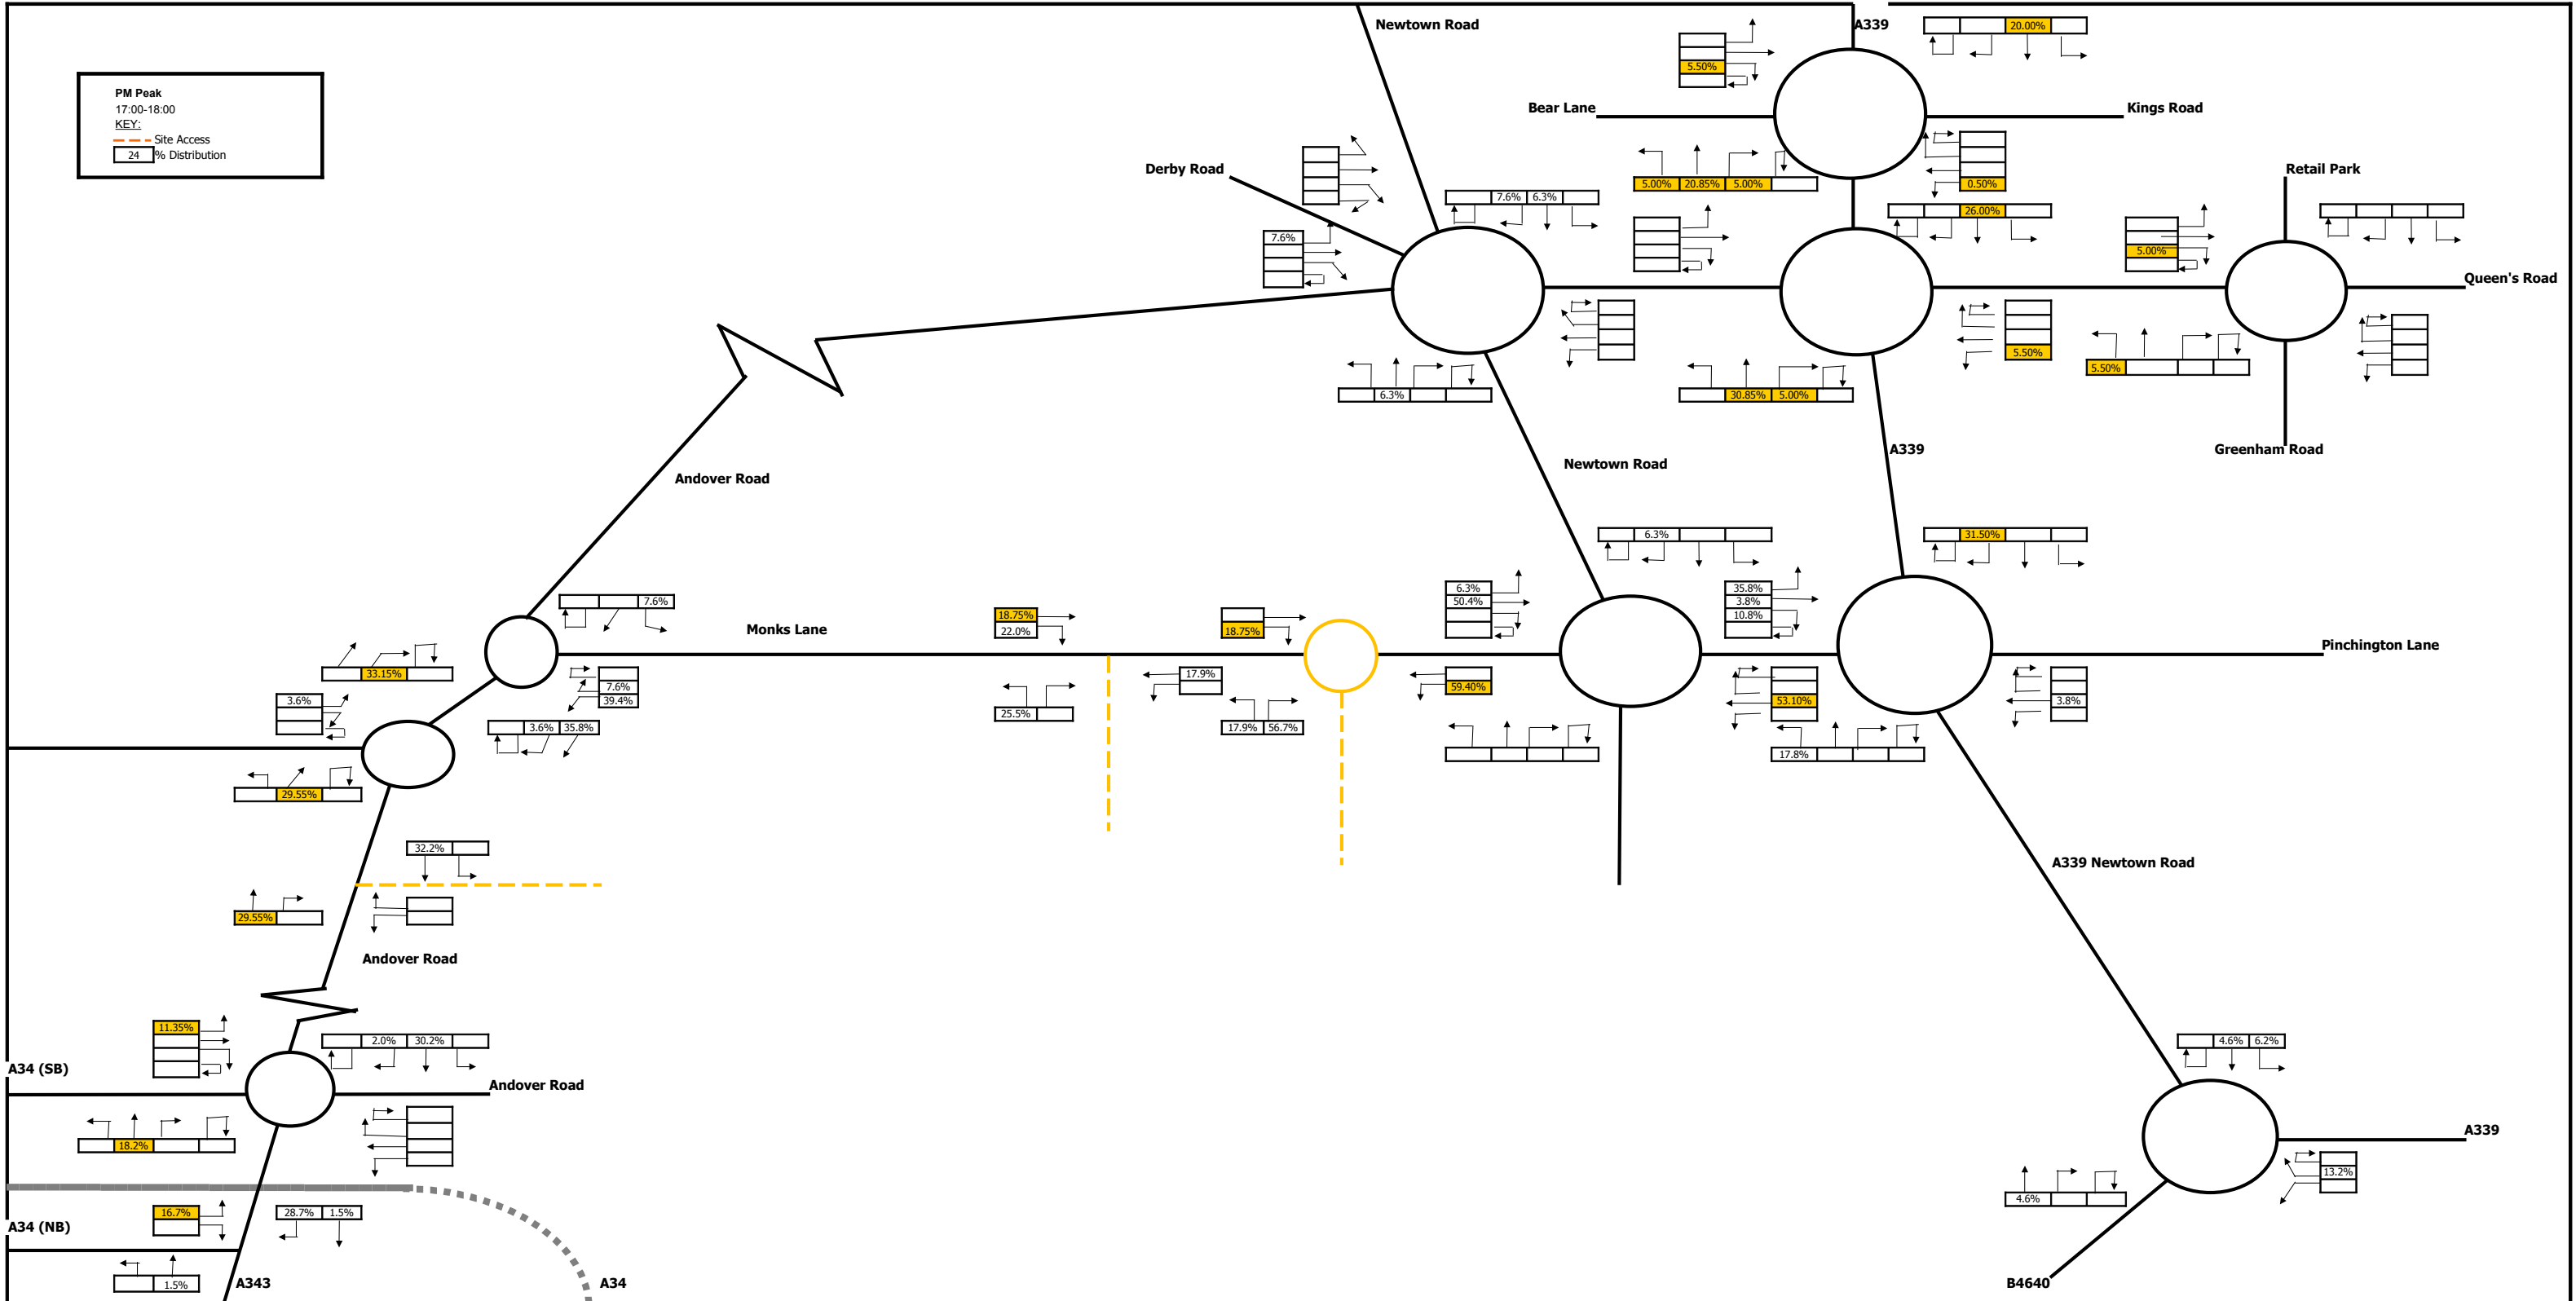

Rev	Team	Drawn	Checked	Approved
A	2818	CL	AW	MG
Project No.	File name			
A057750	Sandleford Park			

Client	Skilldraw Limited	
Project	Sandleford Park, Newbury	
Title	PM Peak - Distribution	


Ropemaker Court
12 Lower Park Row
Bristol
BS1 5BN

Telephone: (0117) 311 6387
Facsimile: (0117) 925 4239
Email: sba@sba.co.uk

 Savell Bird & Axon
part of the WYG group

 2017

AM Peak
8:00-9:00
KEY:
- Site Access
24 PCUs

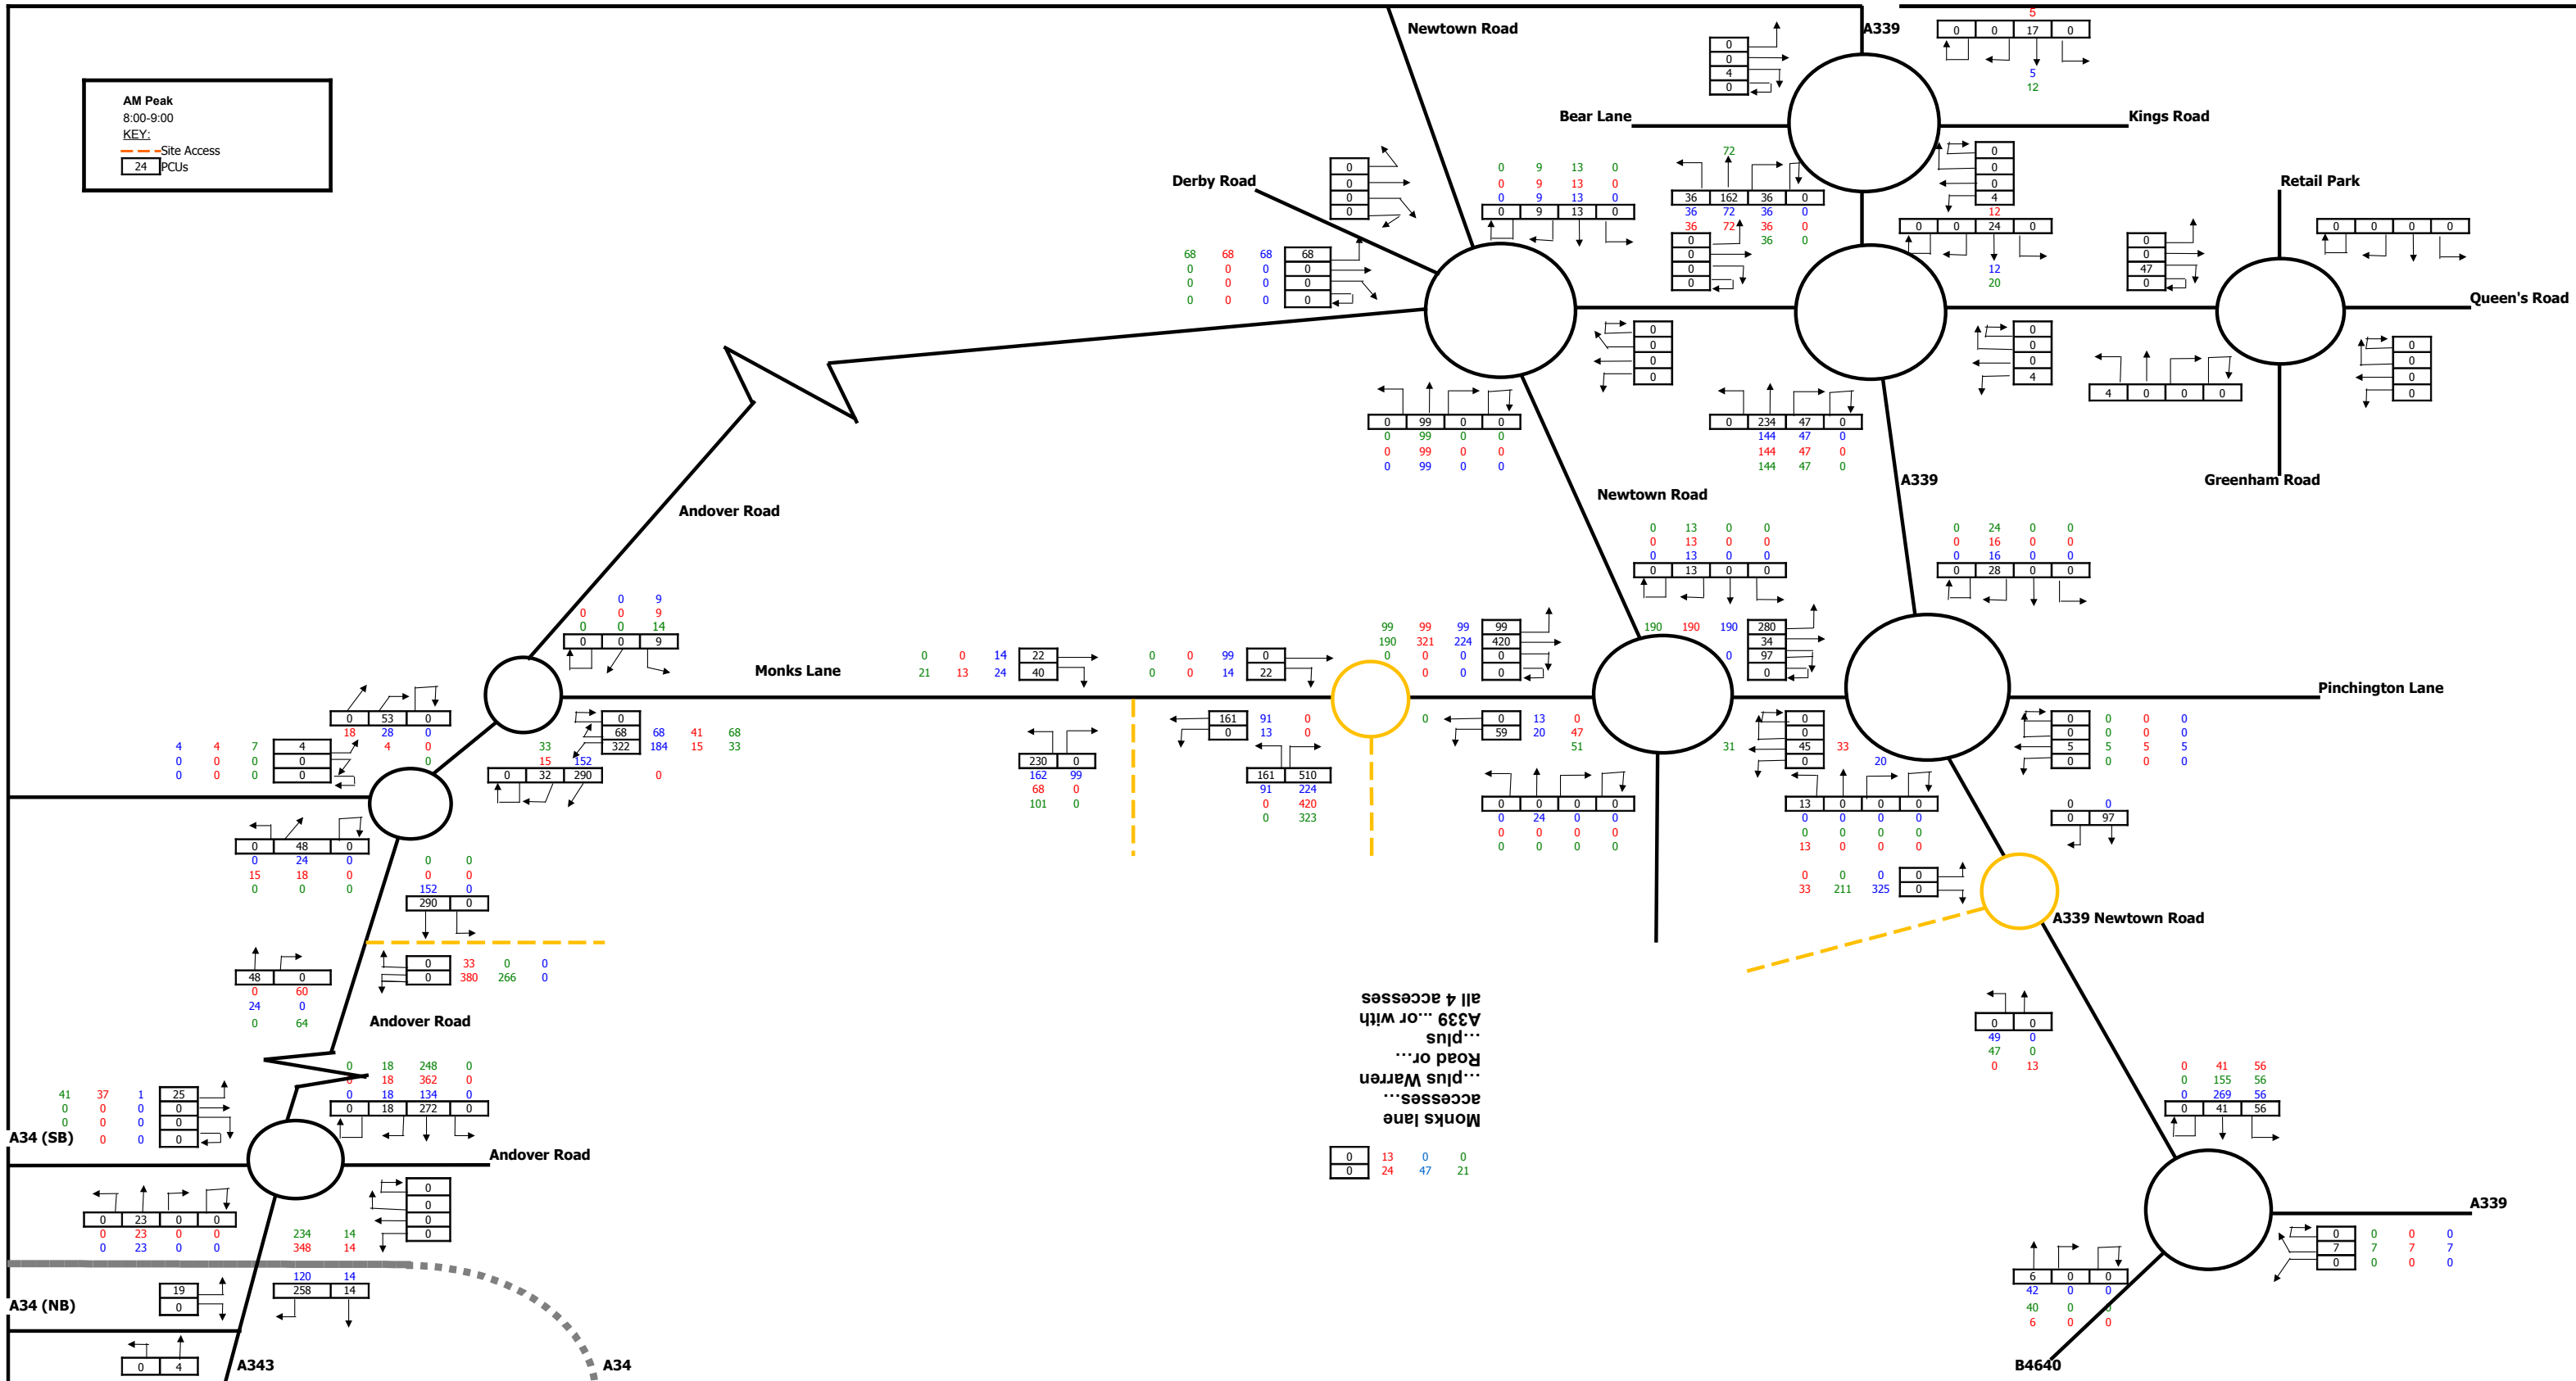

Monks lane
accesses...
...plus Warren
Road or...
...plus
A339...or with
all 4 accesses


0	13	0	0
0	24	47	21

Client					Skilldraw Limited				
Rev					Project				
A	2818	CL	AW	MG	Sandleford Park, Newbury				
Project No.		File name			Title				
A057750		Sandleford Park			Development Traffic - AM Peak				

Client					Skilldraw Limited				
Rev					Project				
A	2818	CL	AW	MG	Sandleford Park, Newbury				
Project No.		File name			Title				
A057750		Sandleford Park			Development Traffic - AM Peak				


Ropemaker Court
12 Lower Park Row
Bristol
BS1 5BN

Telephone: (0117) 311 6387
Facsimile: (0117) 925 4239
Email: sba@sbox.co.uk



Savell Bird & Axon
part of the WYG group

PM Peak
17:00-18:00
KEY:
- Site Access
24 PCUs

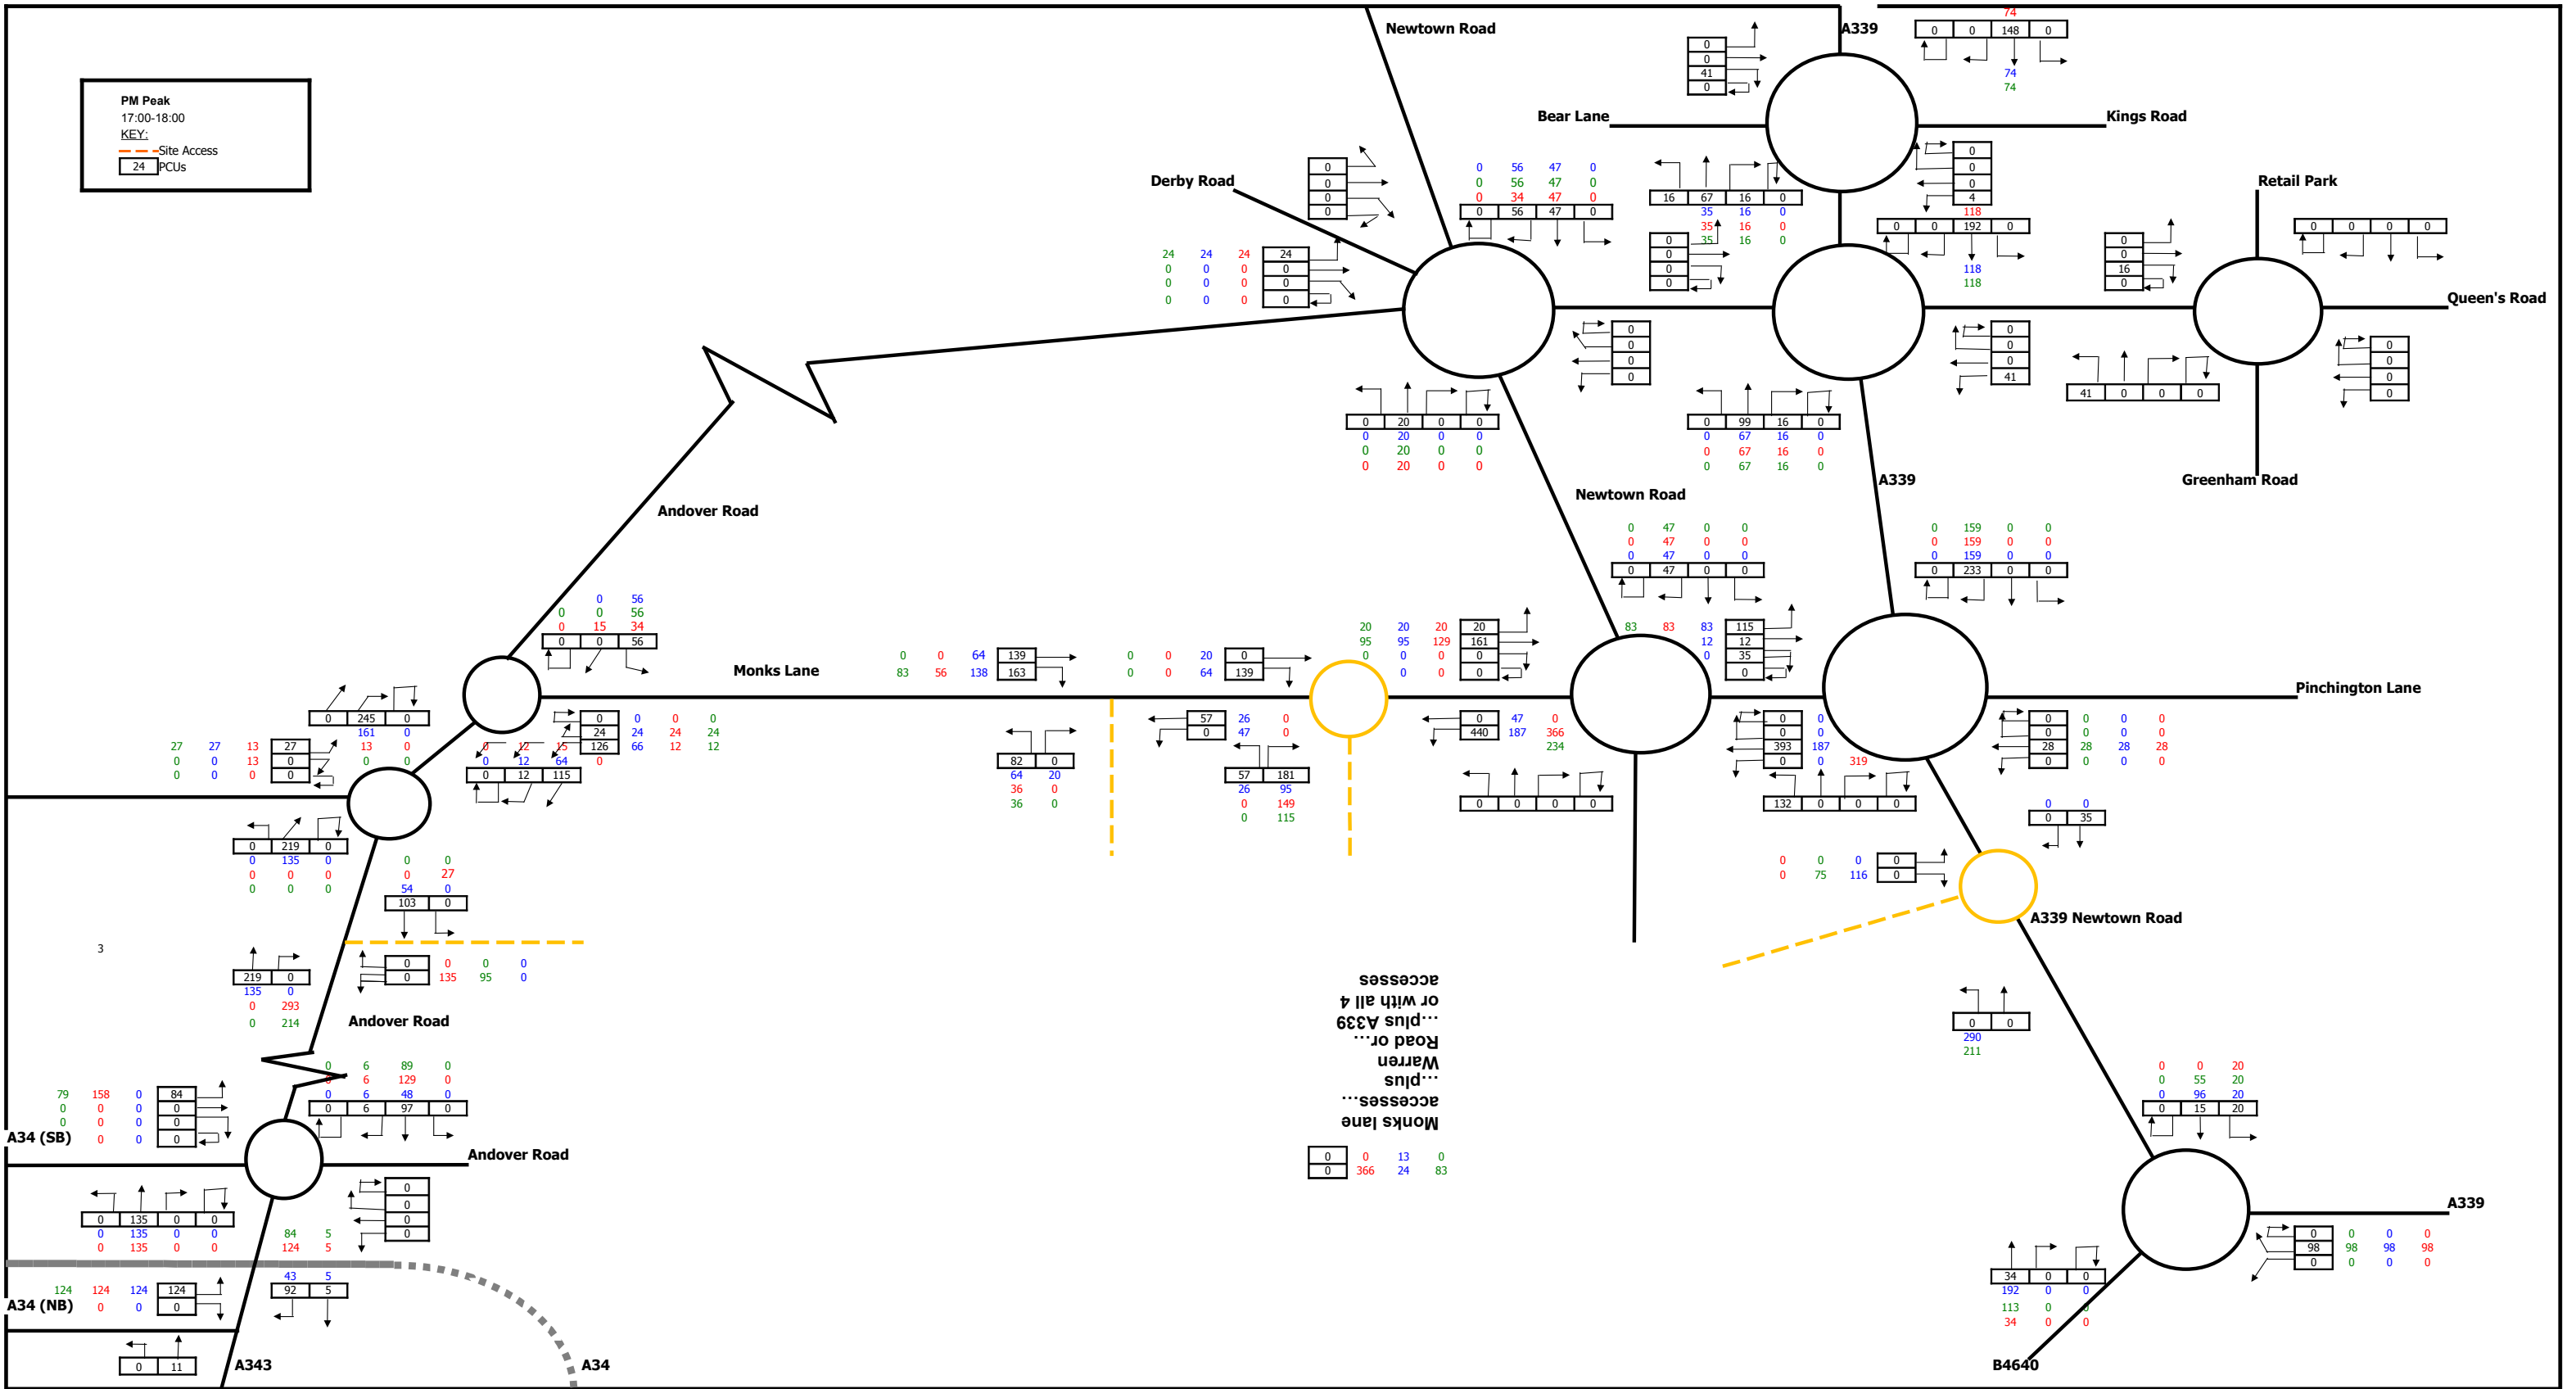

Rev	Team	Drawn	Checked	Approved
A	2818	CL	AW	MG
Project No.	File name			
A057750	Sandford Park			

Client	Skilldraw Limited			
Project	Sandford Park, Newbury			
Title	Development Traffic - PM Peak			

Ropemaker Court
12 Lower Park Row
Bristol
BS1 5BN

Telephone: (0117) 311 6387
Facsimile: (0117) 925 4239
Email: sba@sbox.co.uk



Savell Bird & Axon
part of the WYG group